



3/4" STUCCO OVER MTL LATHE/VP  
OVER 1/2" DENSEGLASS OVER 6" -10 GA  
MTL STUDS @ 12" OC, BRACE STUDES TO  
COL @ 24" OC VERT

STRUCT STEEL COLUMN REF STRUCT DRWGSS

**03 PLAN DETAIL @ PORTA CACHE**  
1"=1'-0"

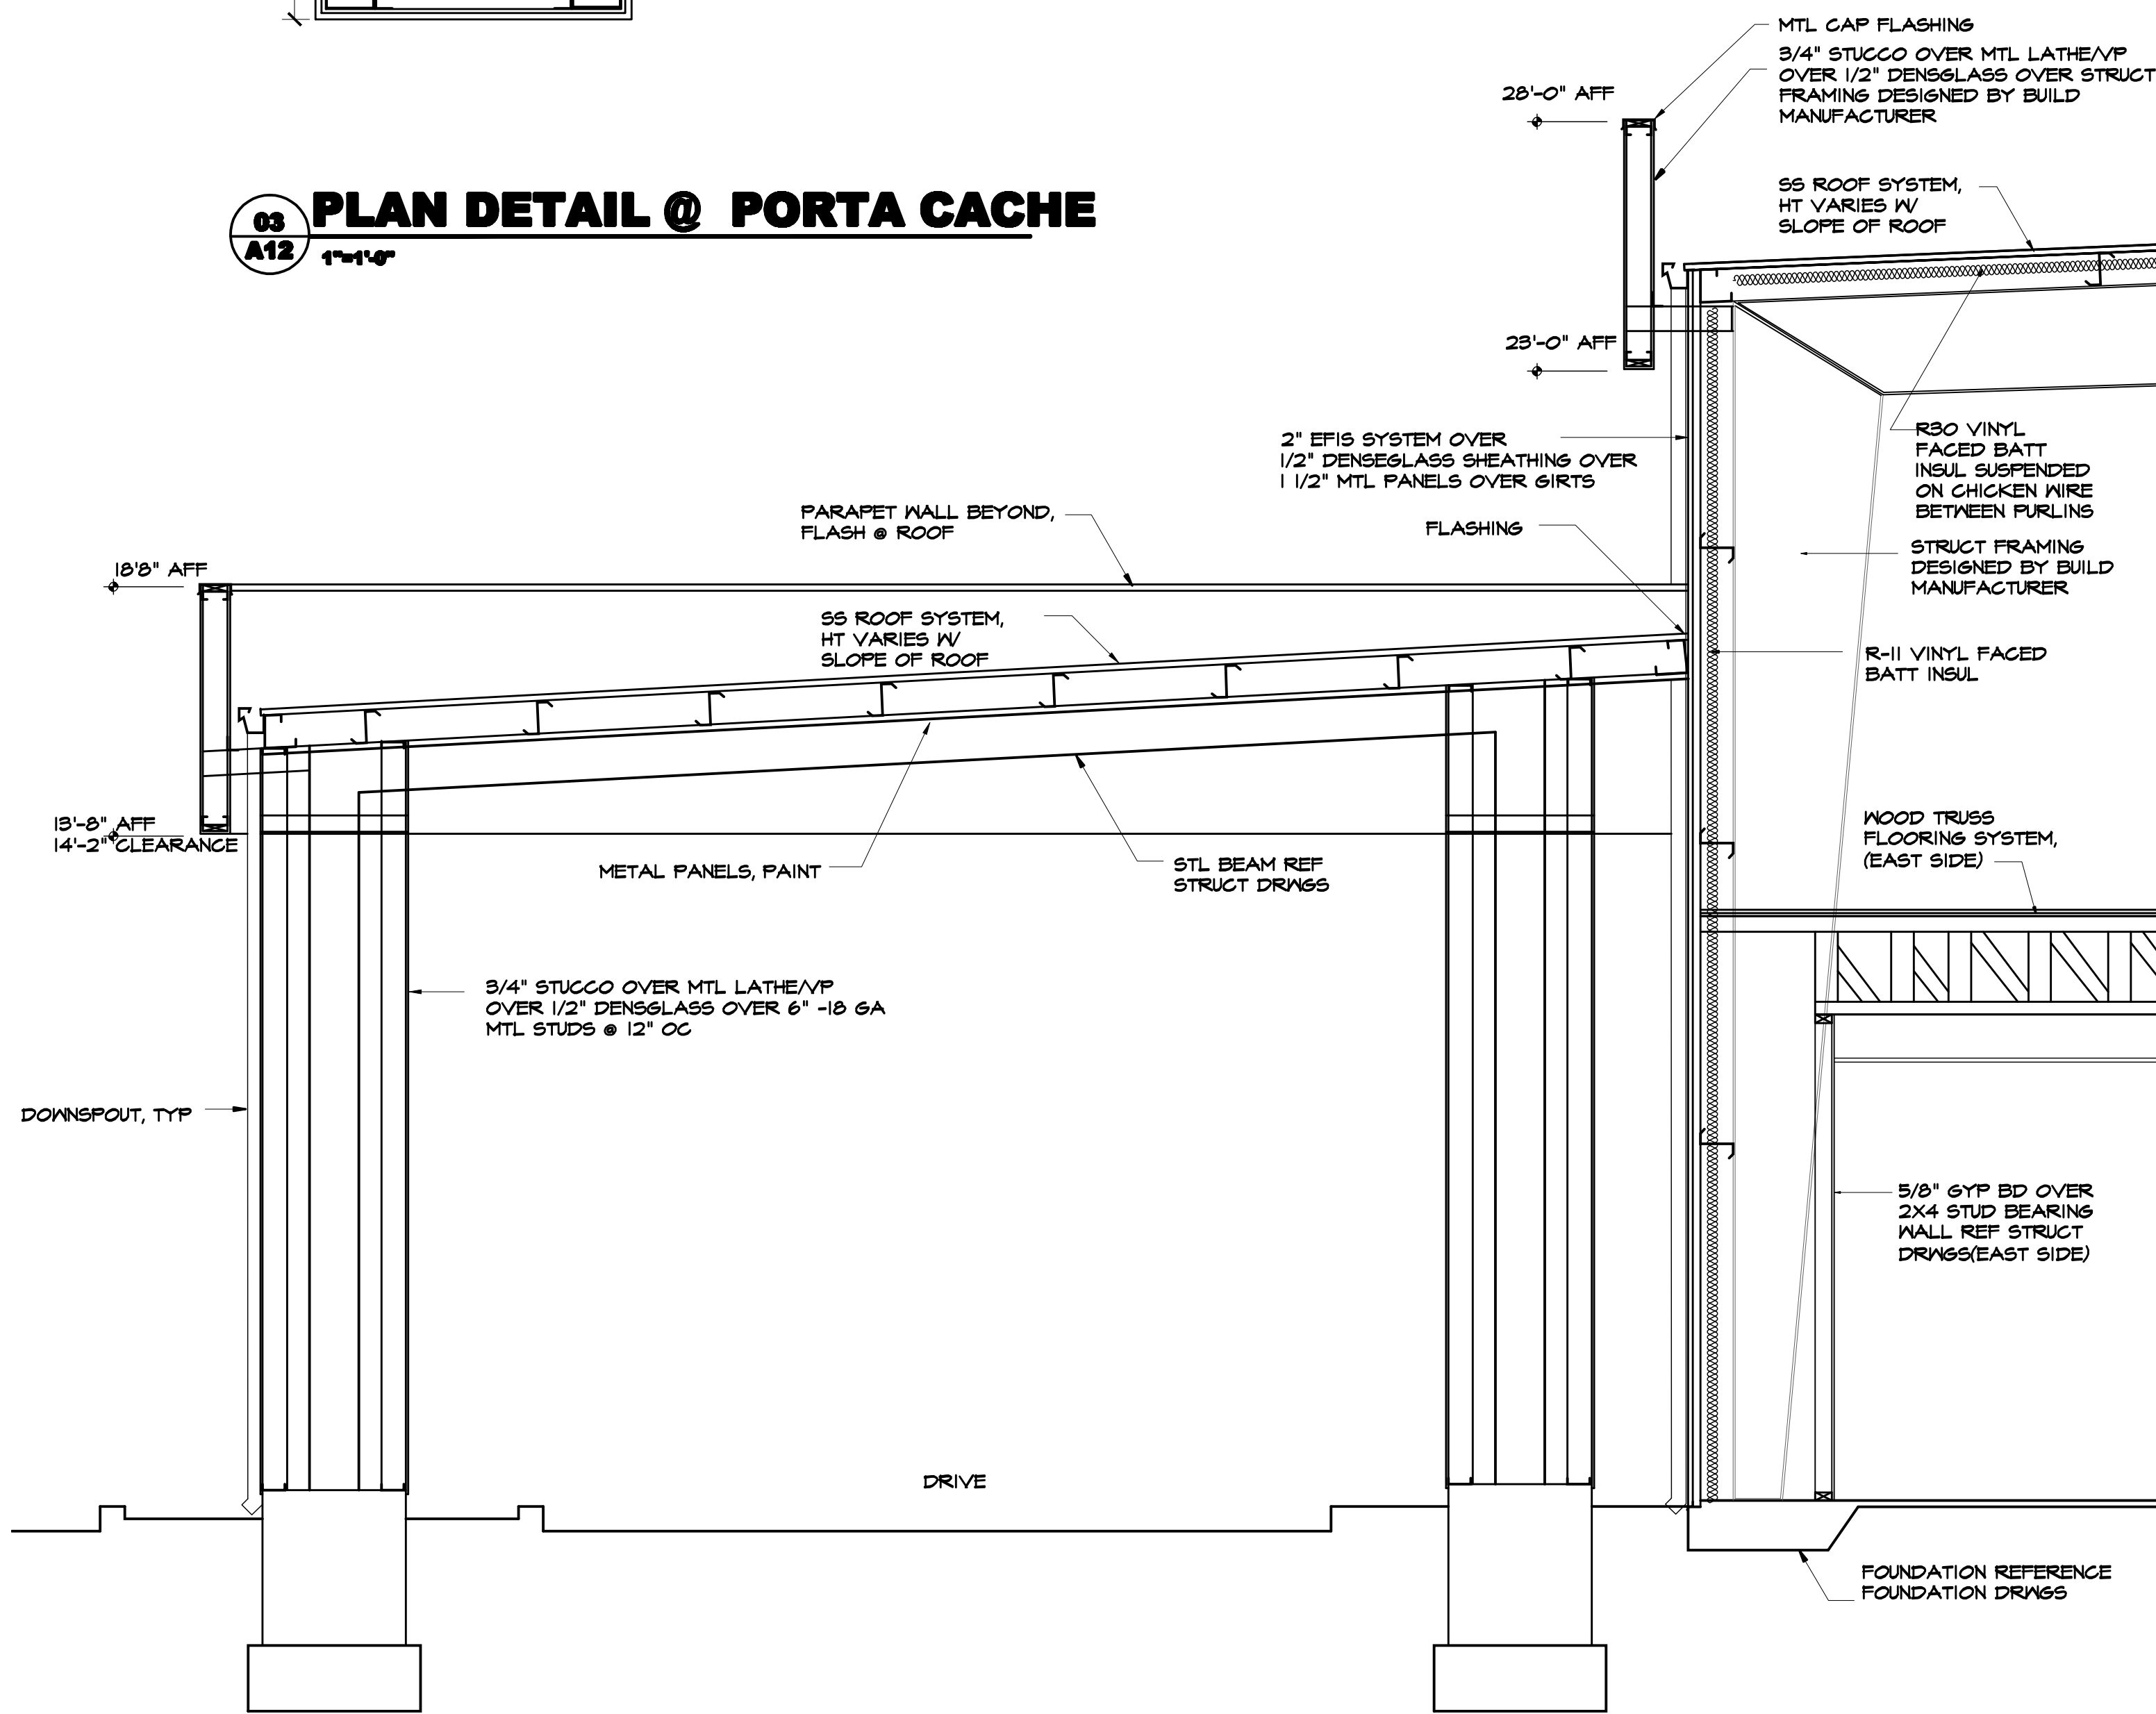

**02 SECTION THRU PORTA CACHE**  
3/8"=1'-0"

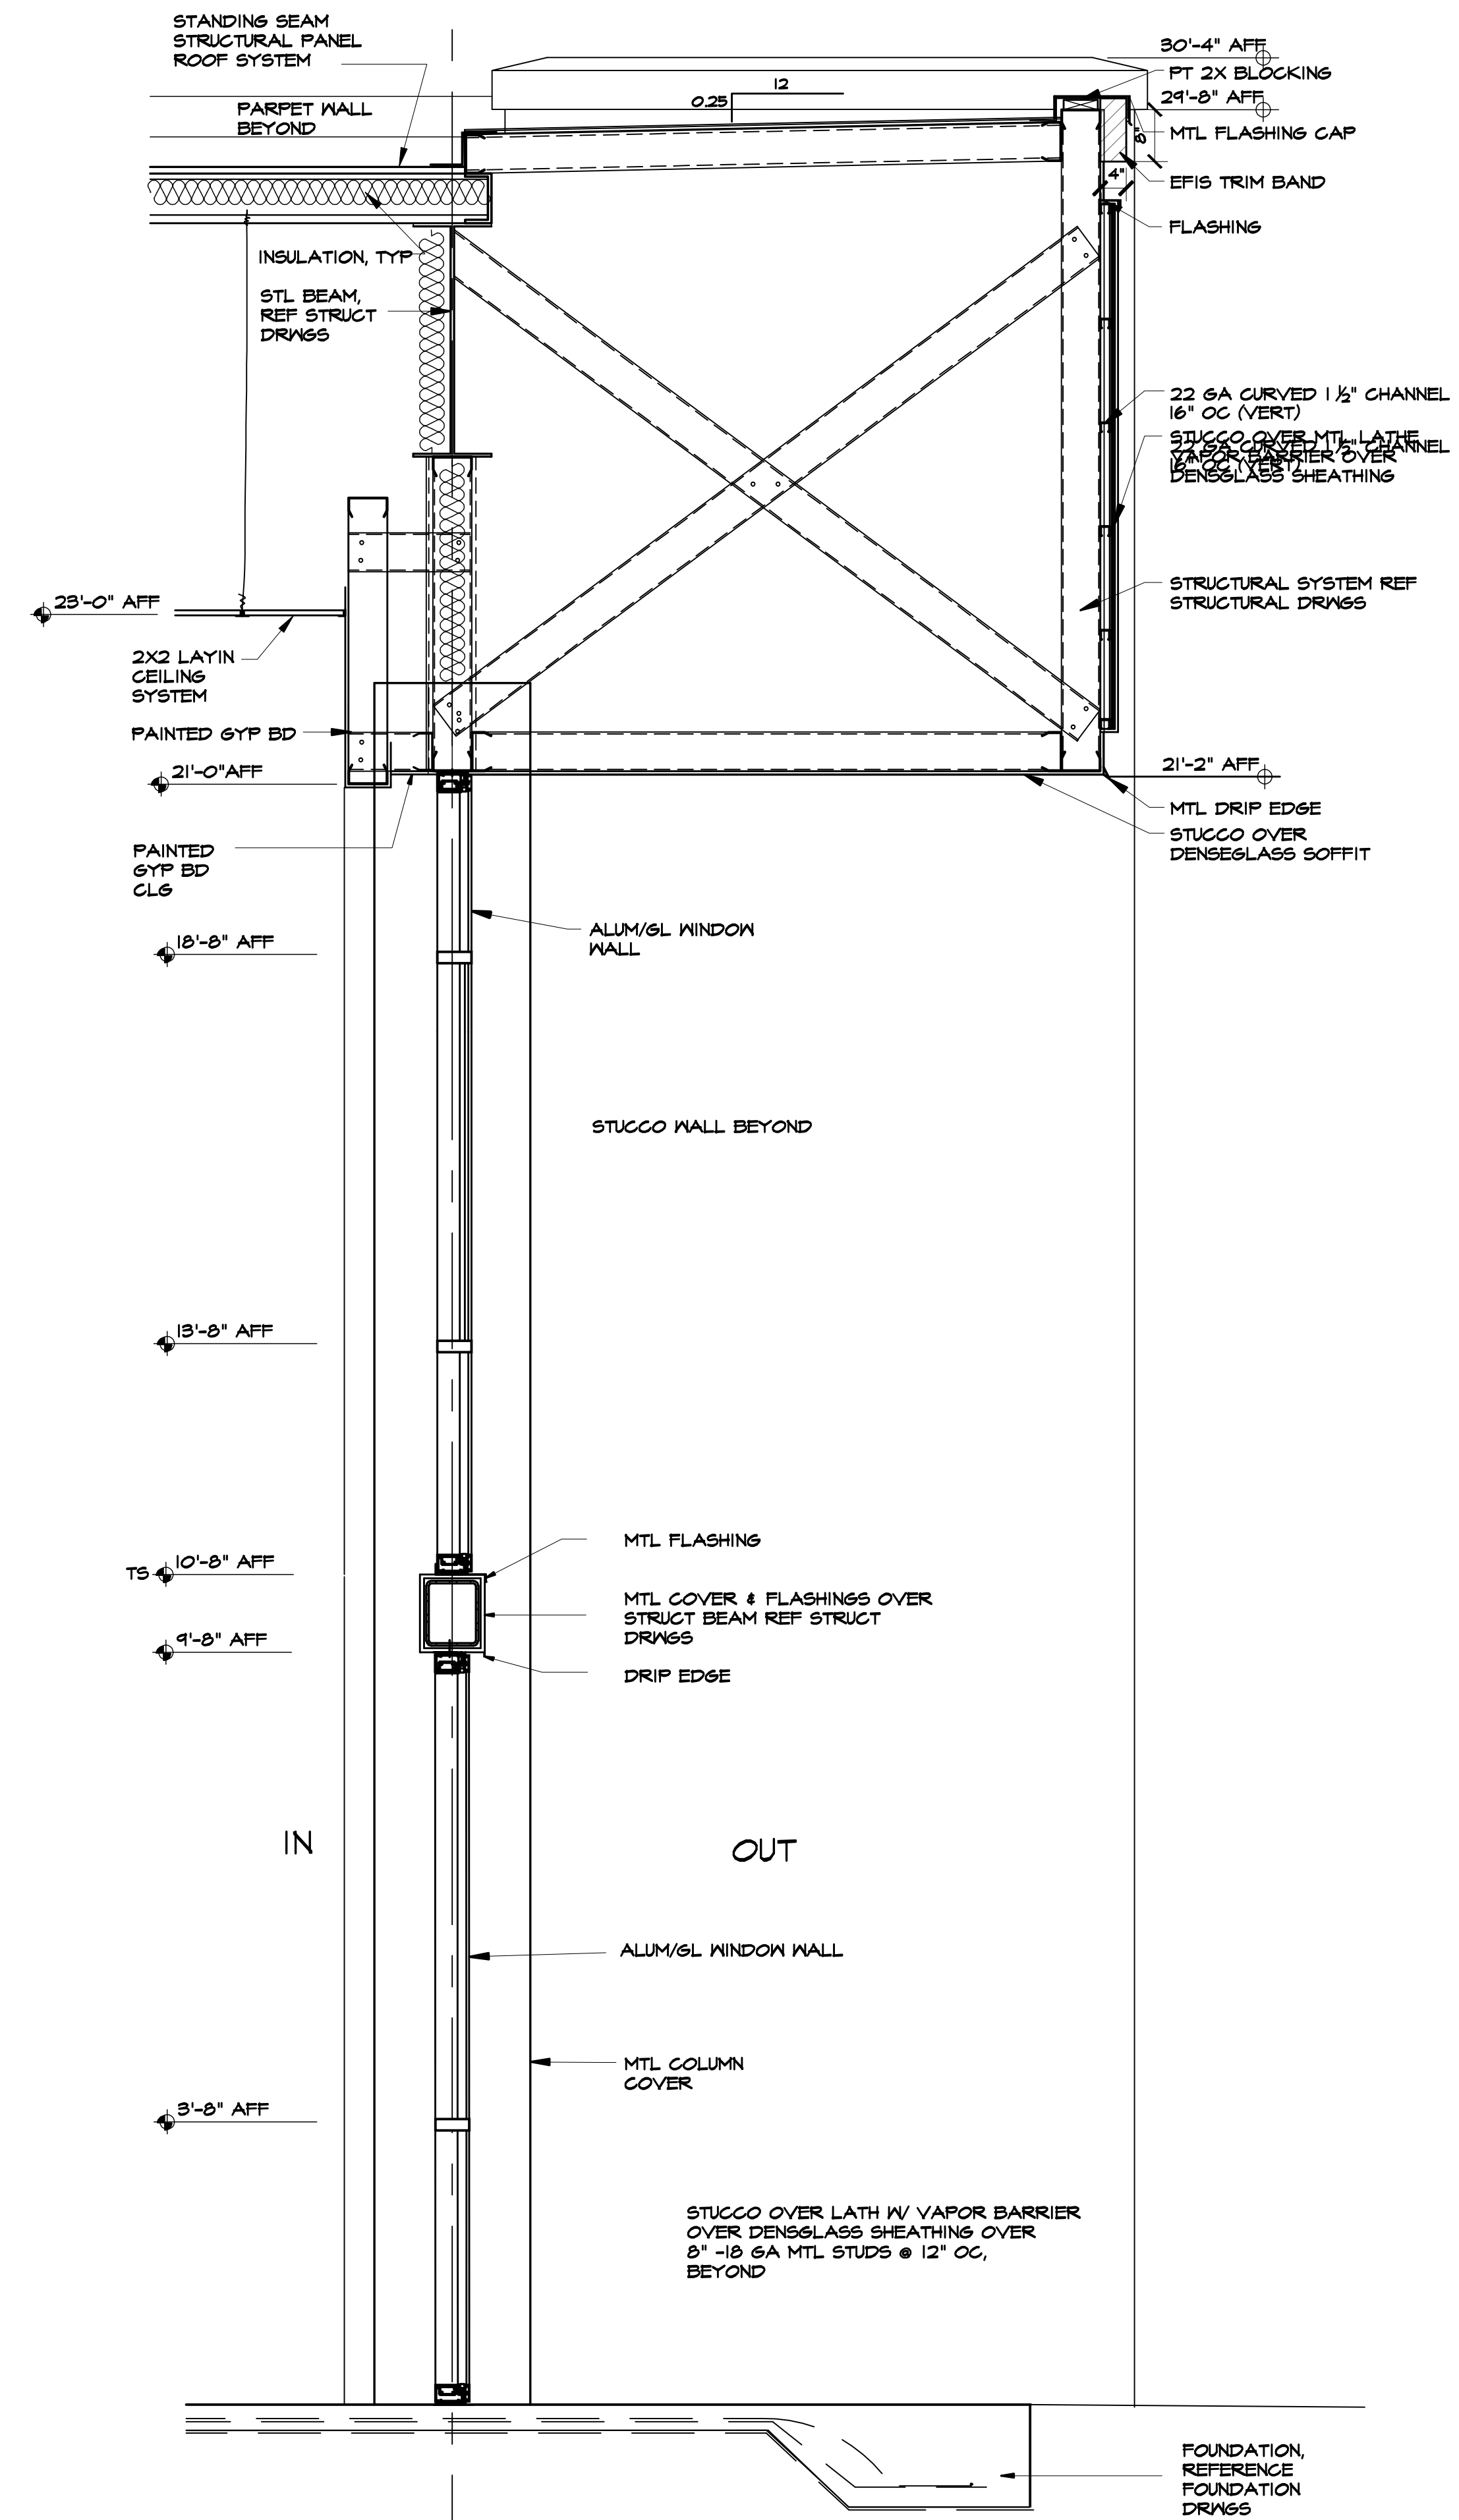

**01 WALL SECTION**  
3/8"=1'-0"

**COPYRIGHT STATEMENT:**  
THESE DOCUMENTS AND THEIR CONTENTS ARE THE PROPERTY OF DON BRYANT ARCHITECTS, INC. (DBA) AND ARE ISSUED ONLY FOR THE SPECIFIC PROJECT NOTED ON THESE DOCUMENTS. ANY REVISIONS, REPRODUCTIONS, OR MODIFICATIONS OF THESE DOCUMENTS WITHOUT THE EXPRESS WRITTEN CONSENT OF (DBA) IS PROHIBITED BY LAW.

SUBMISSIONS:		
NOV 26 2010	PRELIMINARY	
DEC 6, 2010	REVIEW	
JAN 3, 2011	PERMIT REVIEW	
FEB 11, 2011	RESPONSE TO COMMENTS	1
MAR 2, 2011	RESPONSE TO COMMENTS	2
JUNE 10, 2011	CORRIDOR DETAILS	
JUNE 27, 2011	REVISIONS	3
SEPT 7, 2011	FIRE CORRIDOR REVISIONS	
NOV 14, 2011	SECOND FLOOR DECK	
JAN 18, 2011	AS-BUILTS	

SEAL

PROJECT: PROPOSED NEW SANCTUARY FOR  
**DISCOVER LIFE CHURCH**  
EAU GALIE BLVD  
MELBOURNE, FLORIDA

**DON R. BRYANT**  
ARCHITECT  
AR 13733

349 N. PLANTERS STREET  
EMORY, TEXAS 75440

OFFICE: (321) 722-4992  
FAX: (321) 735-9443

EMAIL: villagearchitect@yahoo.com

WEBSITE: [WWW.VILLAGEARCHITECT.COM](http://WWW.VILLAGEARCHITECT.COM)

ARCHITECTURE  
PLANNING  
DESIGN

TITLE:  
**WALL SECTIONS**

COMMISSION:	SHEET:
2010.603	<b>A12</b>
	OF 24